


DRAWING NUMBER  
A-105  
C. Westrick & Associates  
New York, NY 10048  
M-1


DRAWING NUMBER  
A-105  
C. Westrick & Associates  
New York, NY 10048  
M-1

DRAWING NUMBER  
A-105  
C. Westrick & Associates  
New York, NY 10048  
M-1

DRAWING NUMBER  
A-105  
C. Westrick & Associates  
New York, NY 10048  
M-1

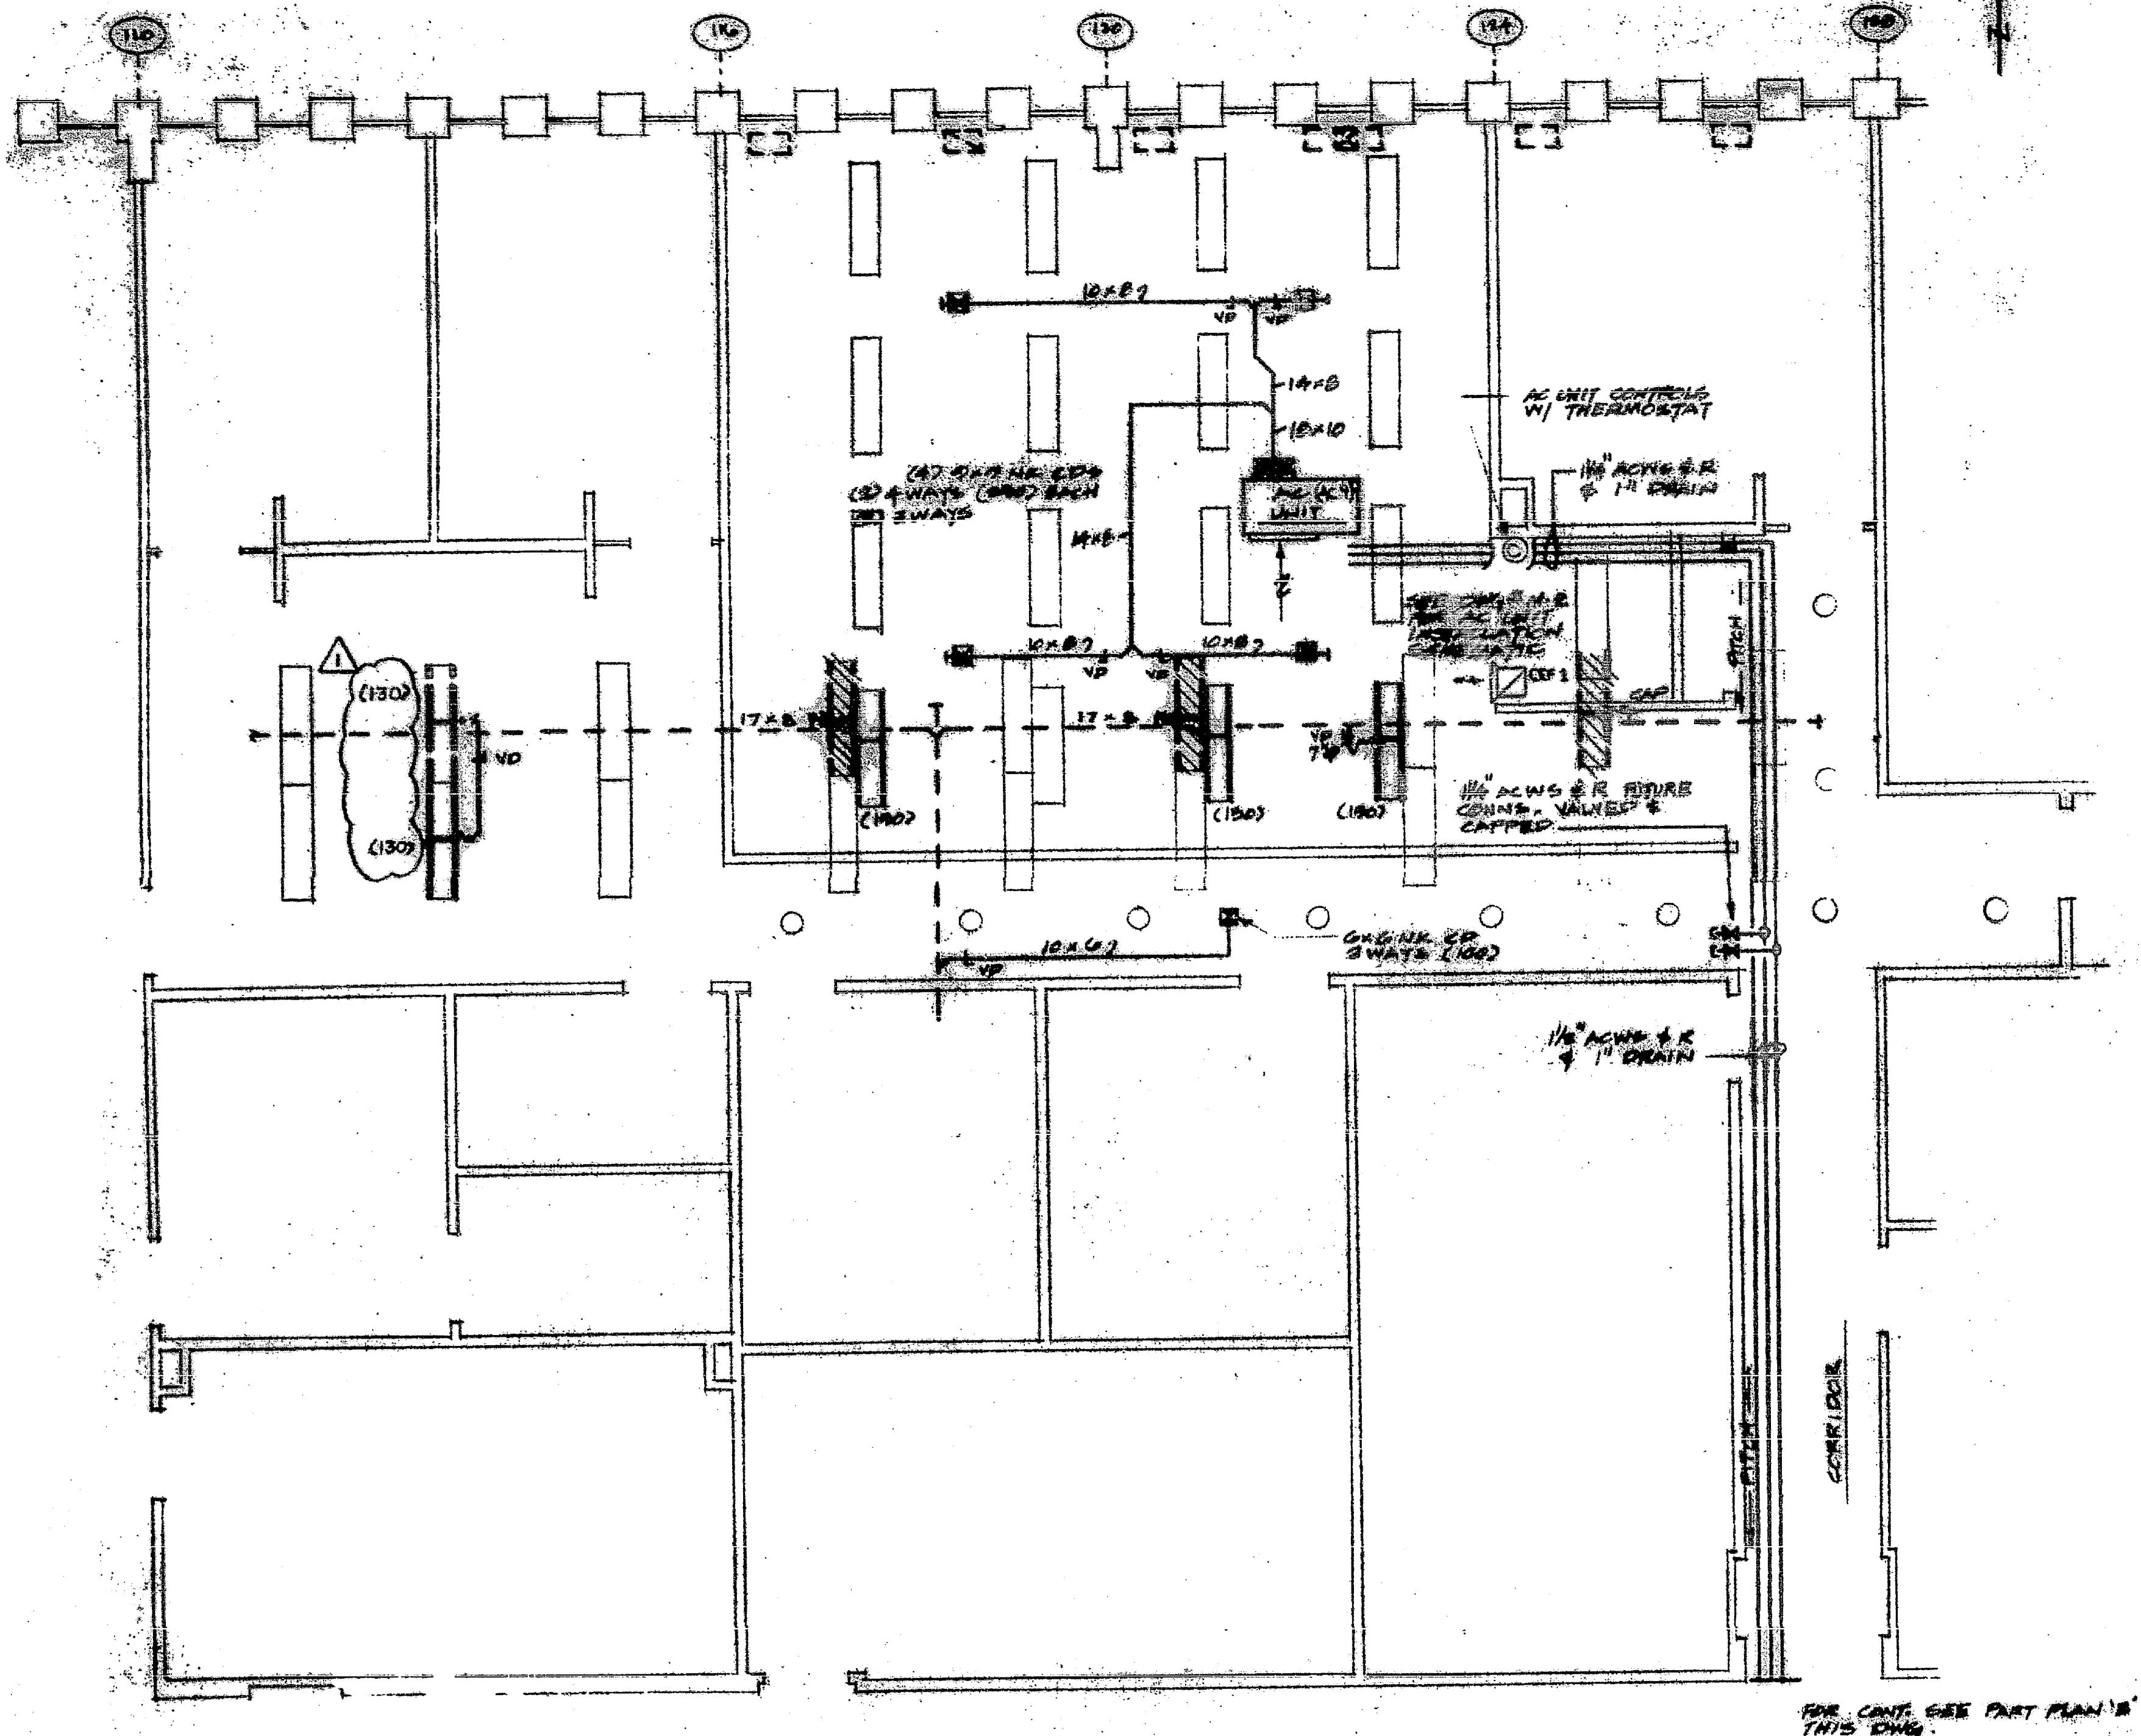

PART PLAN 'A' - 105<sup>TH</sup> FLOOR  
SCALE: 1/8" = 1'-0"

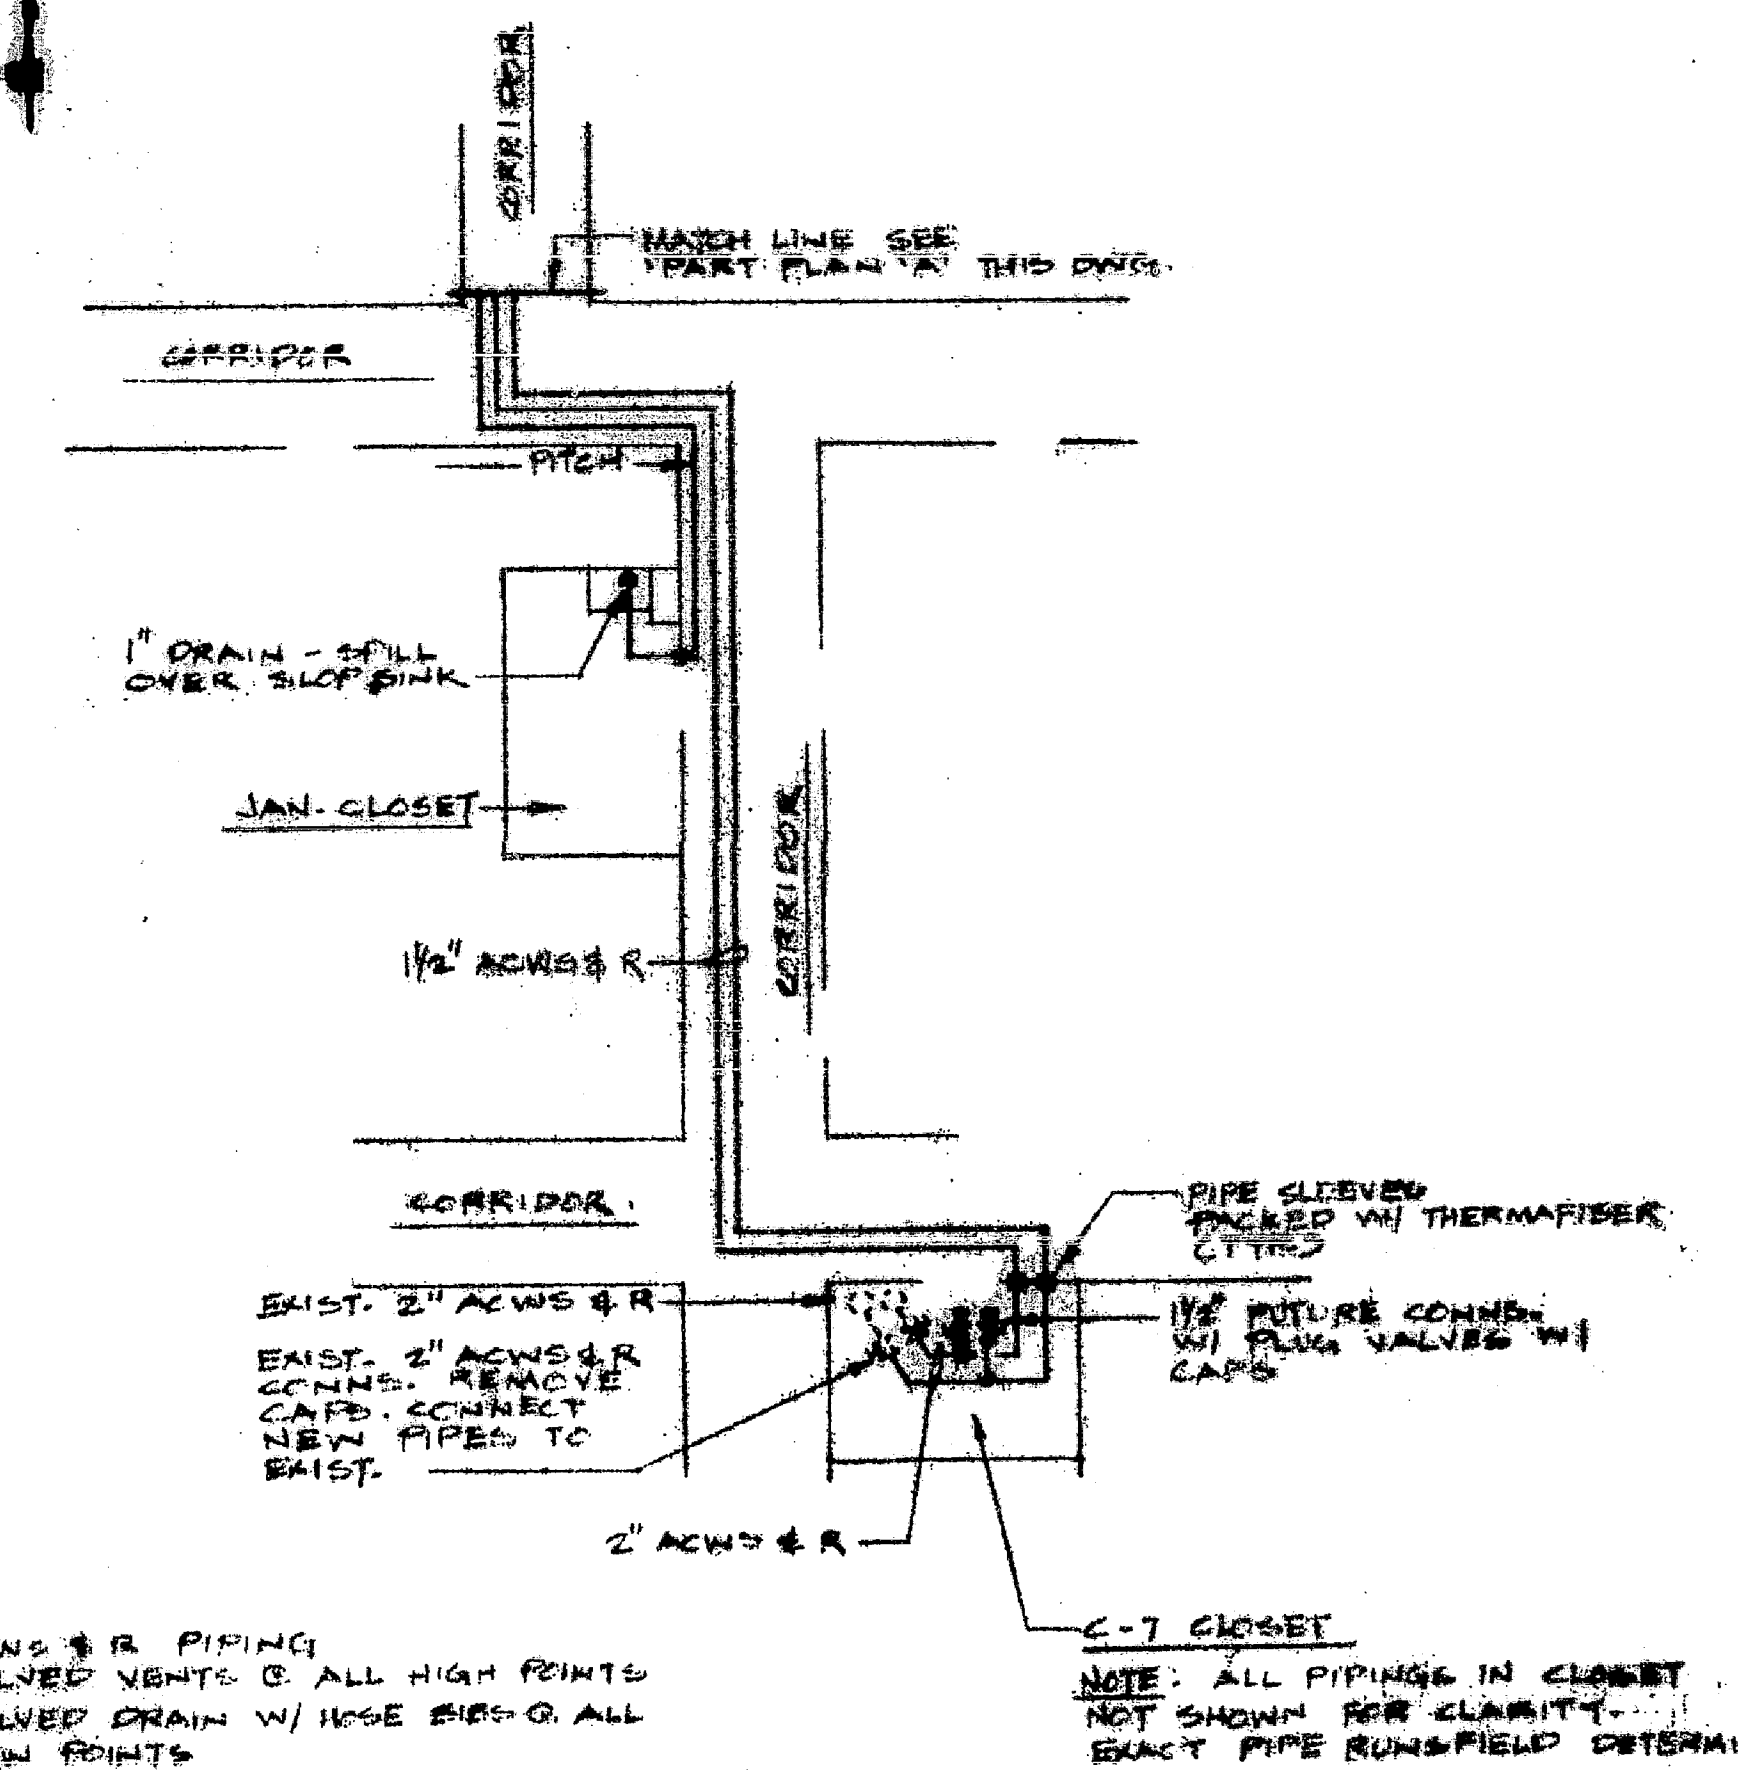


PART PLAN 'B' - 105<sup>TH</sup> FLOOR  
SCALE: 1/8" = 1'-0"

AS-BUILT DRAWING

DATE 5/12/06  
INSPECTOR P. Holberg For P. Bernard

AS-BUILT DRAWINGS  
Revised 5-6-05

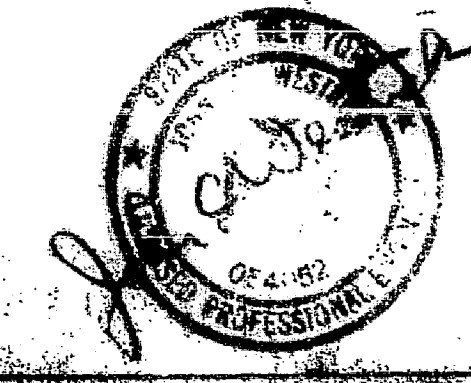

REV. 1	1-16-05	AS PER P.A. COMMENTS
CANTOR FITZGERALD SECURITIES CORP ONE WORLD TRADE CENTER FLOOR 105 NEW YORK, NY 10048		
MECHANICAL PLAN & DETAILS		
JOHN C. WESTRICK & ASSOCIATES CONSULTING ENGINEERS 2110 MAPLE AVENUE SOUTH PLAINFIELD, N.J. 07080		
JOB # 04-47	SUPV. J. C. WESTRICK	DATE 12-1-04
CHK BY J. C. W.	DATE 12-1-04	

